

DART AEROSPACE LTD	Work Order:	21729
Description: Window	Part Number:	D2958
04.04.19 <del>13</del> <del>14</del>		

Drawing: D2958 Rev. A C1

Qty: 10

Step	Location	Procedure	By	Date	Qty
1	EXPEDITING	Issue Work Order	EC	04.10.19	10
2	PURCHASING	Issue P/O: 1001474 Order per Dwg D2958 Supplier: -Canus Material: 1/8" thick clear acrylic sheet Supplier should protect window with protective film <b>Material release note required</b>	EC	04.10.19	10
3	RECEIVING	Receive and Inspect for transit damage <b>Ensure that material release note is attached</b>	EC	04.11.09	20
4	QC	Inspect Level 6	EC	05.01.19	20
5	STORES	Identify and Stock	EC	05.01.13	20
6	EXPEDITING	Close W/O Inspect level 21 Cost / part 43,95 \$ 43,95 <del>540</del> 05/01/19 20	EC	05.01.14	20

Rev	Date	Change	Revised By	Approved
A	00.02.11	New Issue	EC	
B	00.03.10	Now goes on Haas	EC	
C	00.05.19	Added inspect level 8	EC	
D	01.06.04	Done by composite dept.	EC	
E	01.09.25	Done by outside contract	SM	


RELEASED

02/04/16 *EC*



DESIGN	DRAWN BY	DART AEROSPACE LTD HAWKESBURY, ONTARIO, CANADA
CHECKED	APPROVED	DRAWING NO. D2958 REV. C
DATE		SHEET 1 OF 1 SCALE 1:5
01.05.30		TITLE WINDOW
A	00.01.20	NEW ISSUE
B	00.02.23	Ø0.156 HOLES WERE Ø0.141 (NCR 407)
C	01.05.30	REMOVE HOLES, UNIFORMLY SMALLER
CI	IP 01.07.13	UPDATE MATERIAL SPEC.

RELEASED  
01.06.05

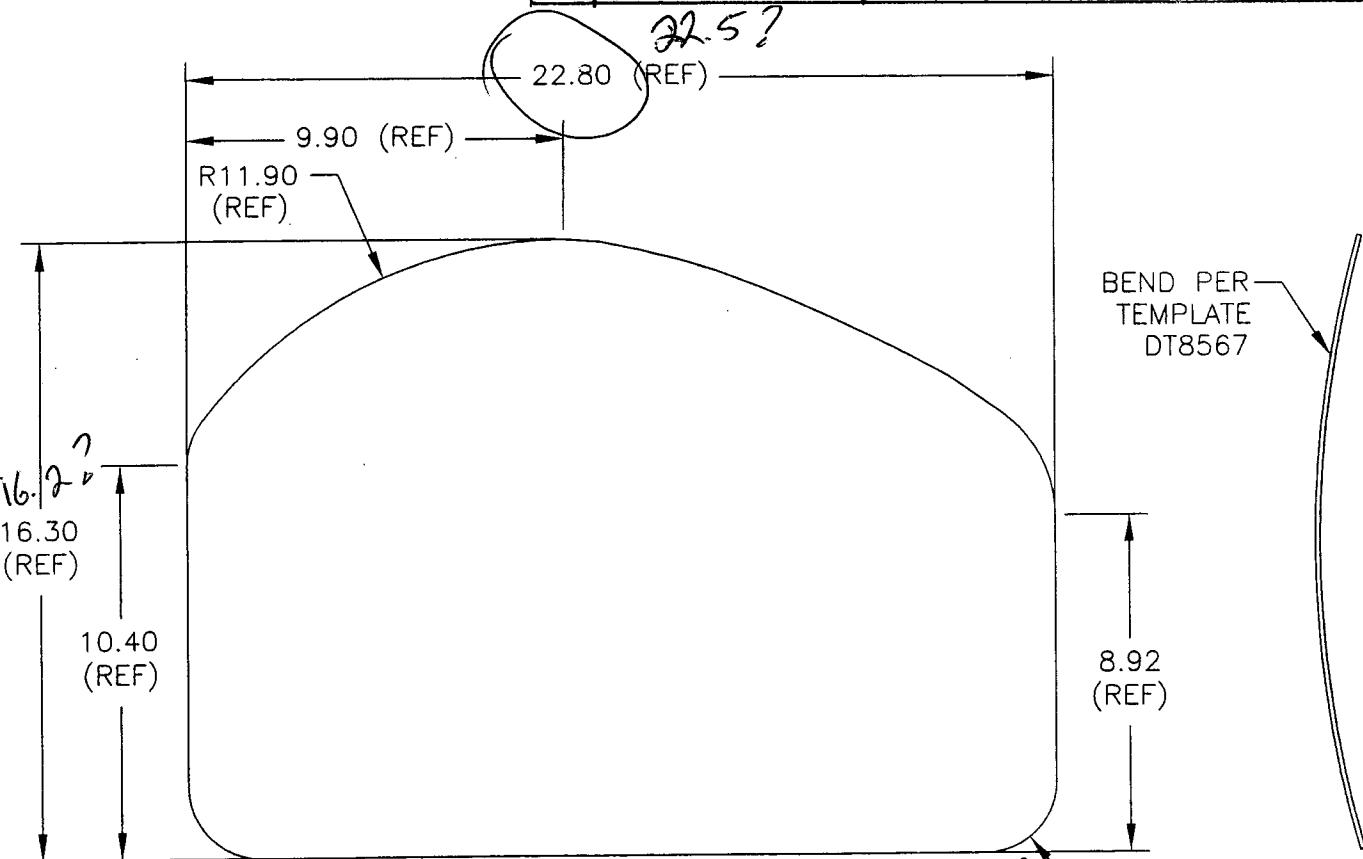

D2958 FLAT PATTERN

SHOP COPY

RETURN TO  
ENGINEERING (TYP 4 PLACES, REF)

UNCONTROLLED COPY  
SUBJECT TO AMENDMENT  
WITH NOTICE

W/ M. ORDER

NO. 21729

D2958


- 1) MATERIAL: 1/8" THICK POLYCARBONATE M- ACRYLIC-S.125 (1/8" ACRYLIC SHEET)
- 2) ROUTER PER TEMPLATE DT8568
- 3) BEND PER TEMPLATE DT8567
- 4) ALL DIMENSIONS ARE IN INCHES
- 5) TOLERANCES ARE PER DART QSI 018 UNLESS OTHERWISE NOTED



Copyright © 2001 by DART AEROSPACE LTD

THIS DOCUMENT IS PRIVATE AND CONFIDENTIAL AND IS SUPPLIED ON THE EXPRESS CONDITION THAT IT IS NOT TO BE USED FOR ANY PURPOSE OR COPIED OR COMMUNICATED TO ANY OTHER PERSON WITHOUT WRITTEN PERMISSION FROM DART AEROSPACE LTD.

At the Linda

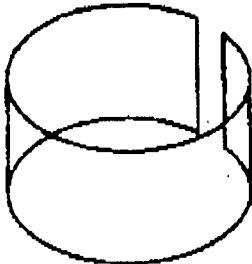

**CANUS Plastics Inc.**  
300 Lisgar Street,  
Ottawa, Ontario, Canada  
K2P 0E2  
Telephone (613) 232-2657

## CERTIFICATE OF CONFORMANCE

**Attention: Receiving Inspection**

The undersigned hereby certifies that the materials supplied and the items shipped herewith under the above purchase order and on the packing slip are in conformance with all contractual applicable government specifications and/or purchase order requirements and that physical and/or chemical reports of the materials supplied are on file and will be made available to the buyer and Government upon request.

QUANTITY	DESCRIPTION	SPECIFICATION #.
<u>20</u>	<u>Molded Windows</u>	<u>D.2958</u> <u>"Rev. C1"</u>

## CANUS PLASTICS INC.

